



1 South Classroom Building Elevation
A-1 SCALE: 1/8" = 1'-0"



2 North Classroom Building Elevation
A-1 SCALE: 1/8" = 1'-0"

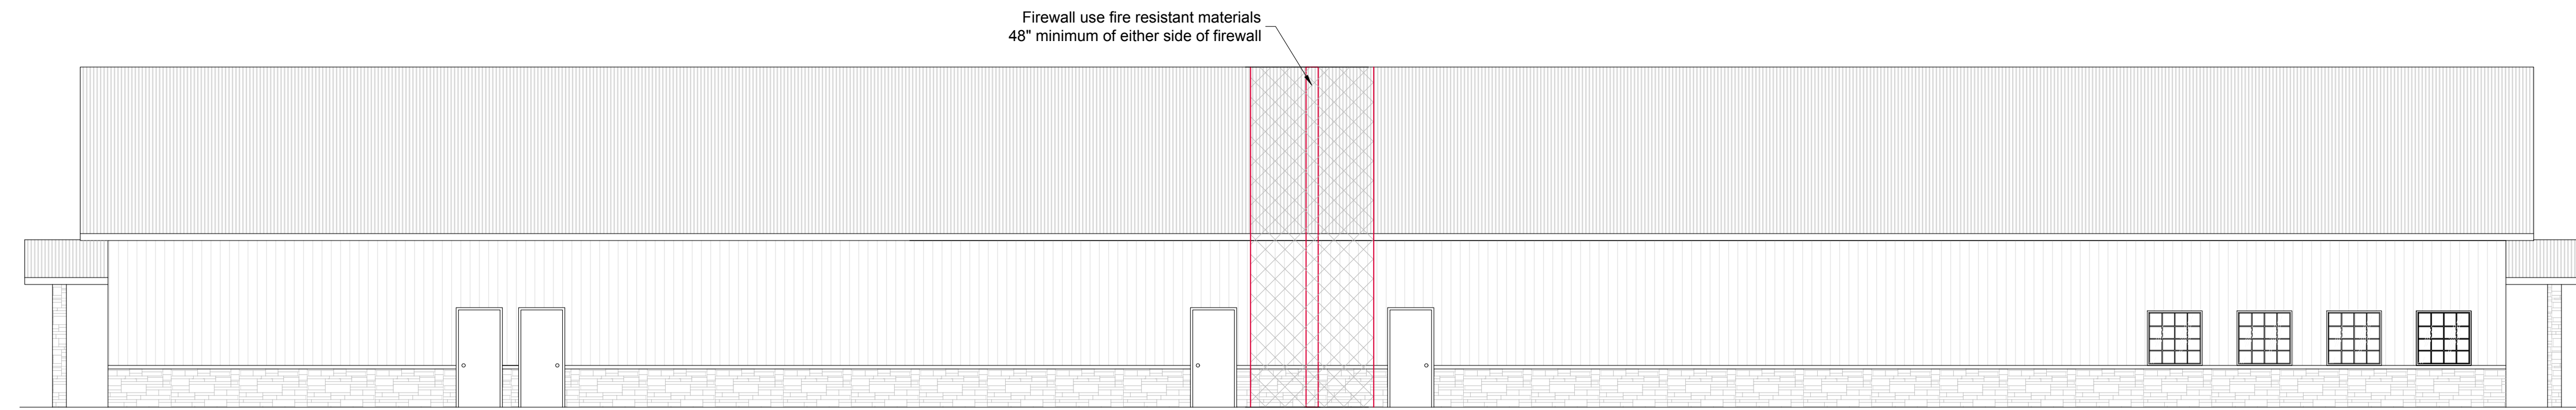

3 West Classroom Building Elevation
A-1 SCALE: 1/8" = 1'-0"

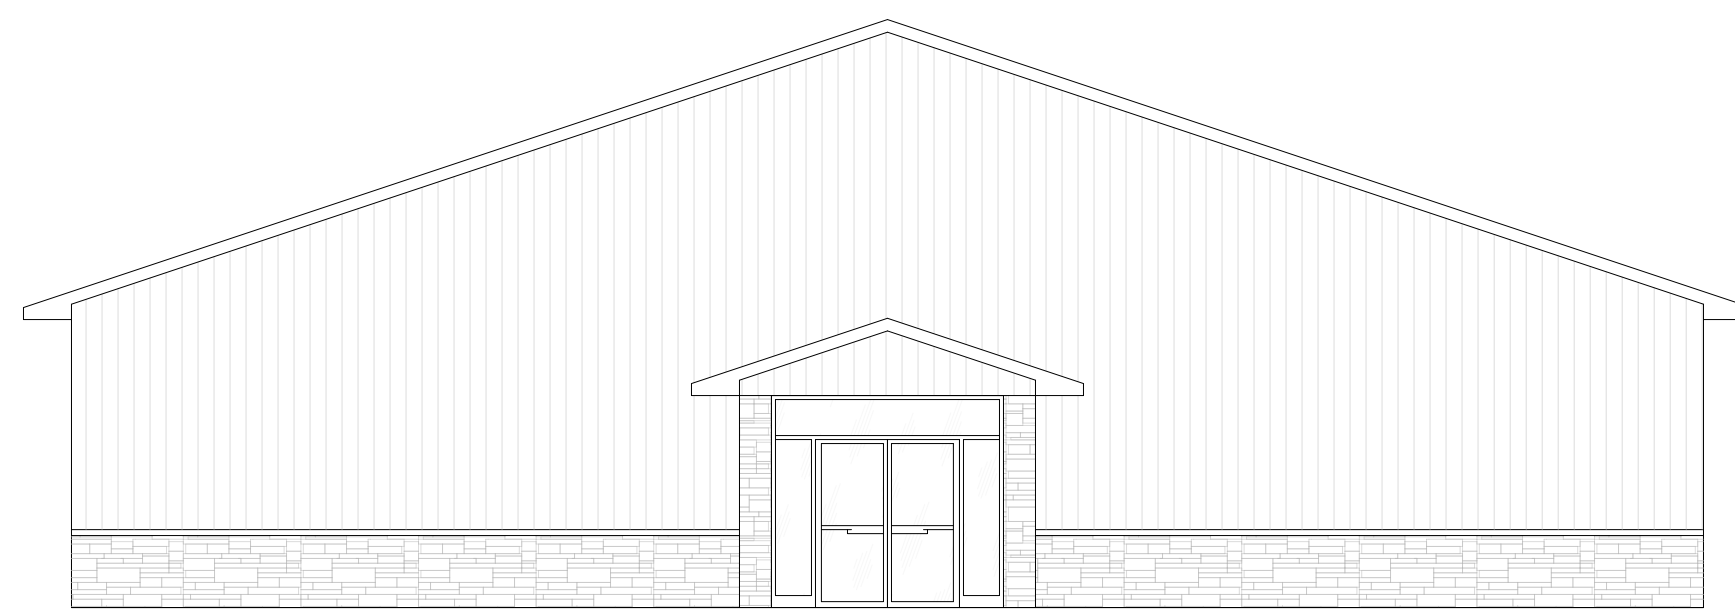

4 East Classroom Building Elevation
A-1 SCALE: 1/8" = 1'-0"

PROJECT NUMBER: P-190321
DRAWN BY: S.E. Bell
DATE: September 30, 2019
SCALE: 1/8" = 1'-0"
REVISED DATE: Revised Nov. 22, 2019 per BFS & Local plan review
REVISED DATE: Nov. 28, 2019 MEP Review, Dec. 23, 2019
ENGINEER: Timothy L. Lapham, P.E., P.E.
SHEET: A-1

Classroom Building Elevations
LAKE SUPERIOR
STATE UNIVERSITY

LAPHAM ASSOCIATES
ENGINEERING
PLANNING
ENVIRONMENTAL
SURVEYING
116 South 3rd Street
West Branch, MI 48661
P (989) 345-5030
F (989) 345-7302
www.laphamassoc.com
© 2019 COPYRIGHT, LAPHAM ASSOCIATES
UNAUTHORIZED COPYING IS PROHIBITED.

APPROVED USE FOR:
○ PRELIMINARY
○ PERMIT/BID
● CONSTRUCTION
○ FINAL RECORD

A-1

